


AS BUILT REVISIONS:

SENSOR IDENTIFICATION				
NO.	SIZE	NO OF TURNS	HOW WIRED	FUNCTION
30421	EXISTING		DIRECT	ØA
30422	EXISTING		DIRECT	ØA
30423	EXISTING		DIRECT	ØA
30424	EXISTING		DIRECT	ØB
30425	EXISTING		DIRECT	ØB
30426	EXISTING		DIRECT	ØB
30427	EXISTING		DIRECT	ØB
30426	6" x 18"	3	DIRECT	ØB
30427	6" x 18"	3	DIRECT	ØB
30428	6" x 18"	3	DIRECT	ØB
30429	6" x 18"	3	DIRECT	ØA


* THIS INDICATION WILL BE FLASHING "WALK" FOLLOWED BY FLASHING "DON'T WALK" UPON ACTUATION OF THE PEDESTRIAN PUSH-BUTTON.

[illegible]

SEE INTERSECTION NO. 304 D FOR QUANTITIES

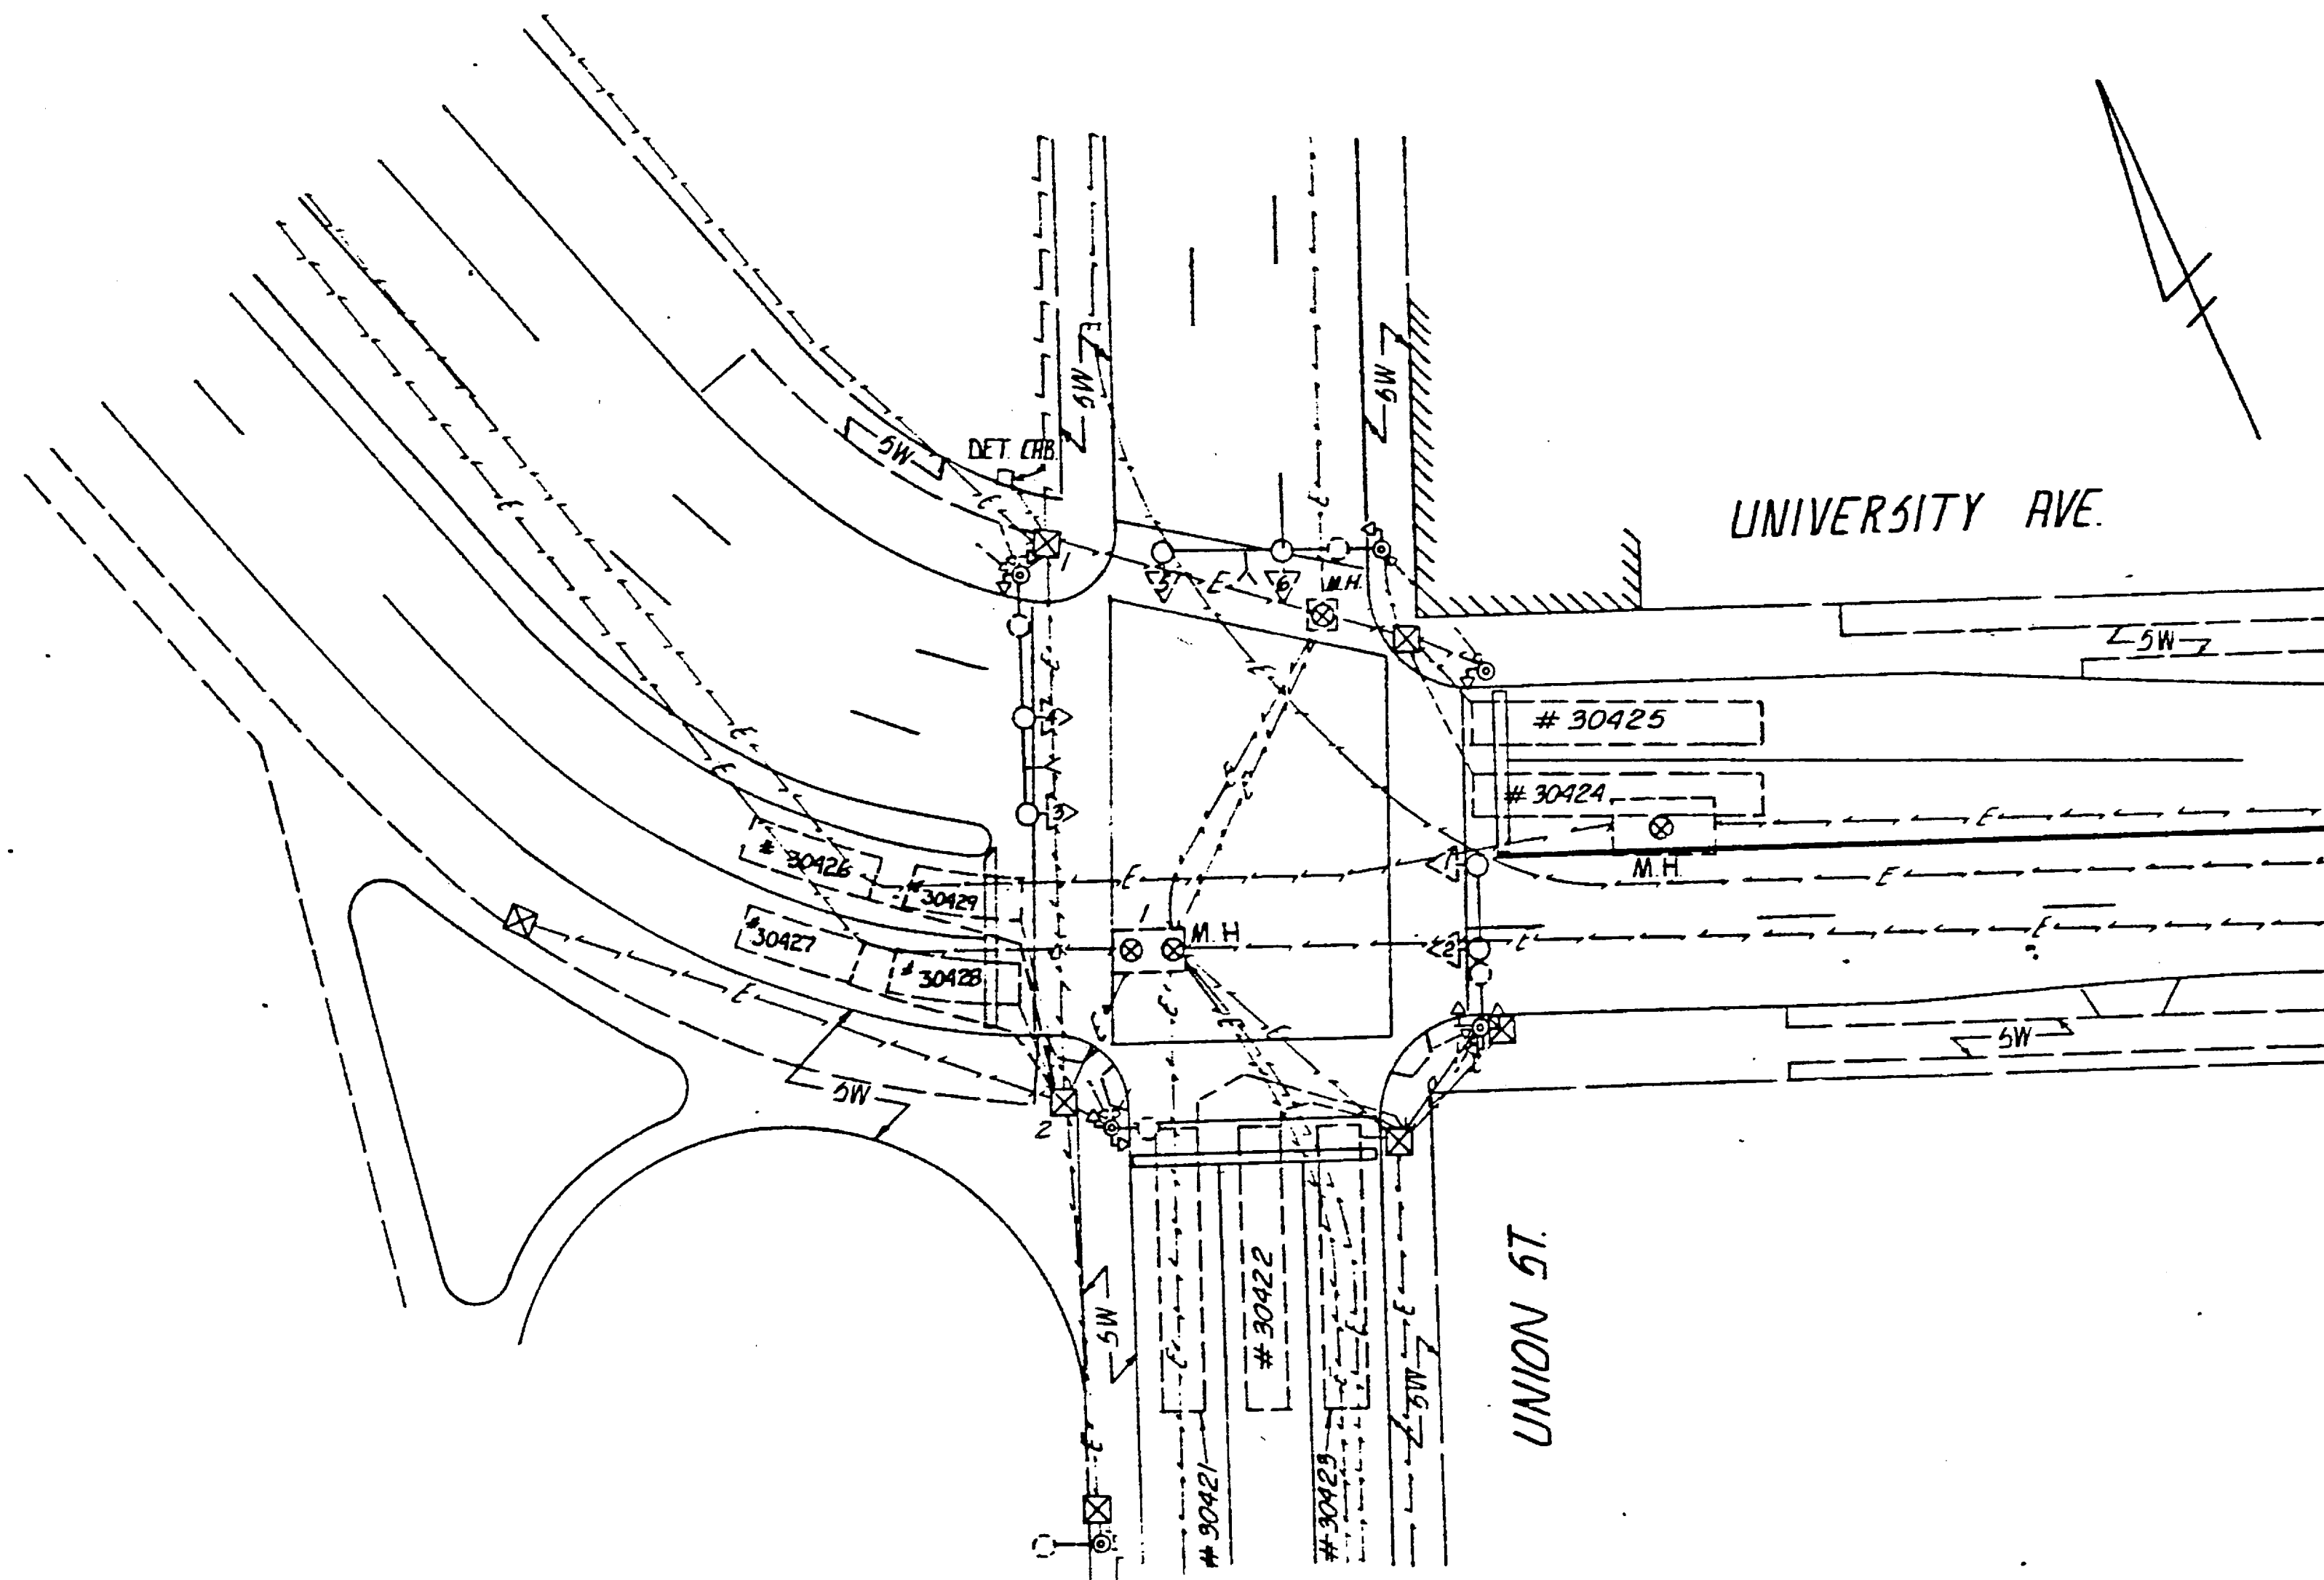

MATCH LINE TO DRAWING NO. 345

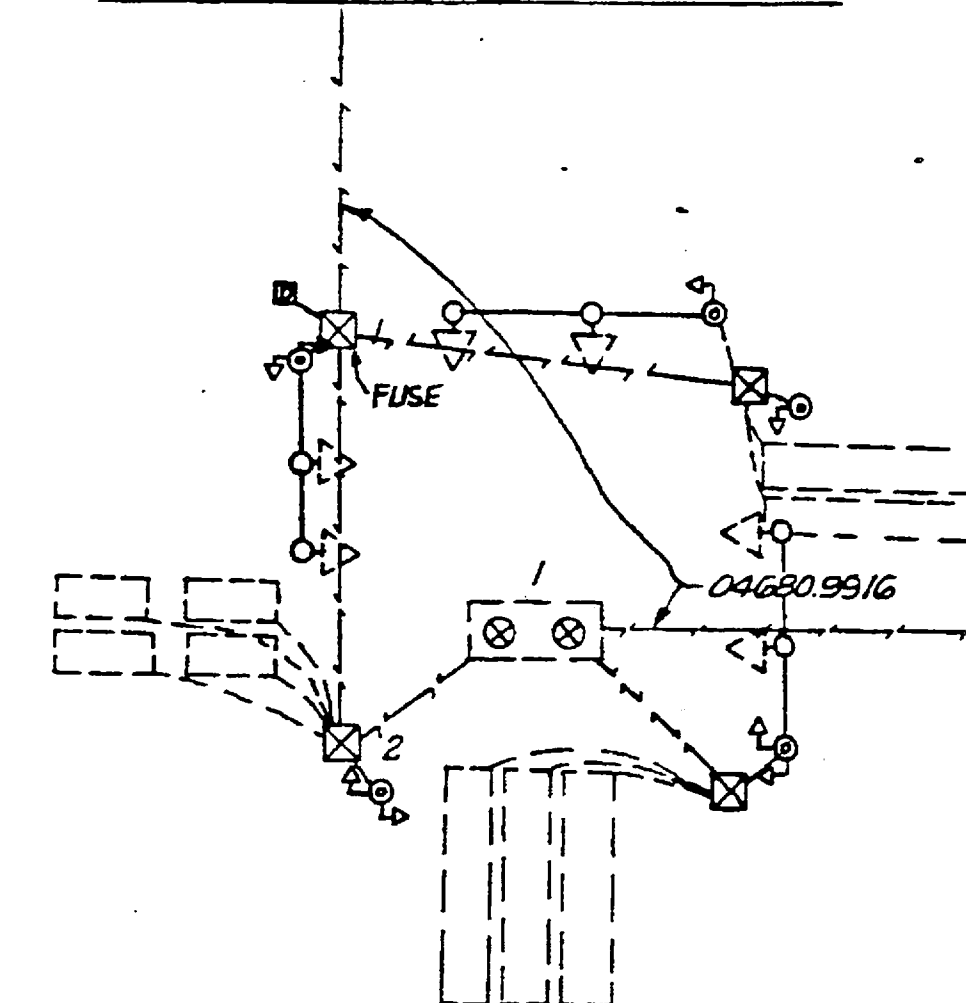

CABLE WIRING DIAGRAM

NOTES:

1. FOR CONTINUATION OF SIGNAL INTERCONNECT, ITEM 04680.9916
SEE COMMUNICATIONS CONDUIT & CABLE SHEETS.

UNIVERSITY AVE & UNION ST. INTERSECTION NO. 304 d			
STATE OF NEW YORK DEPARTMENT OF TRANSPORTATION			
DRAWING No. 20-309	SCALE 1"=20'	DATE 9-22-80	REGION