




CITY OF ROCHESTER

Department of Environmental Services

MAINTENANCE REPAIRS TO CITY BRIDGES & VARIOUS FACILITIES

F.Y. 2016
PROJECT CODE 16228

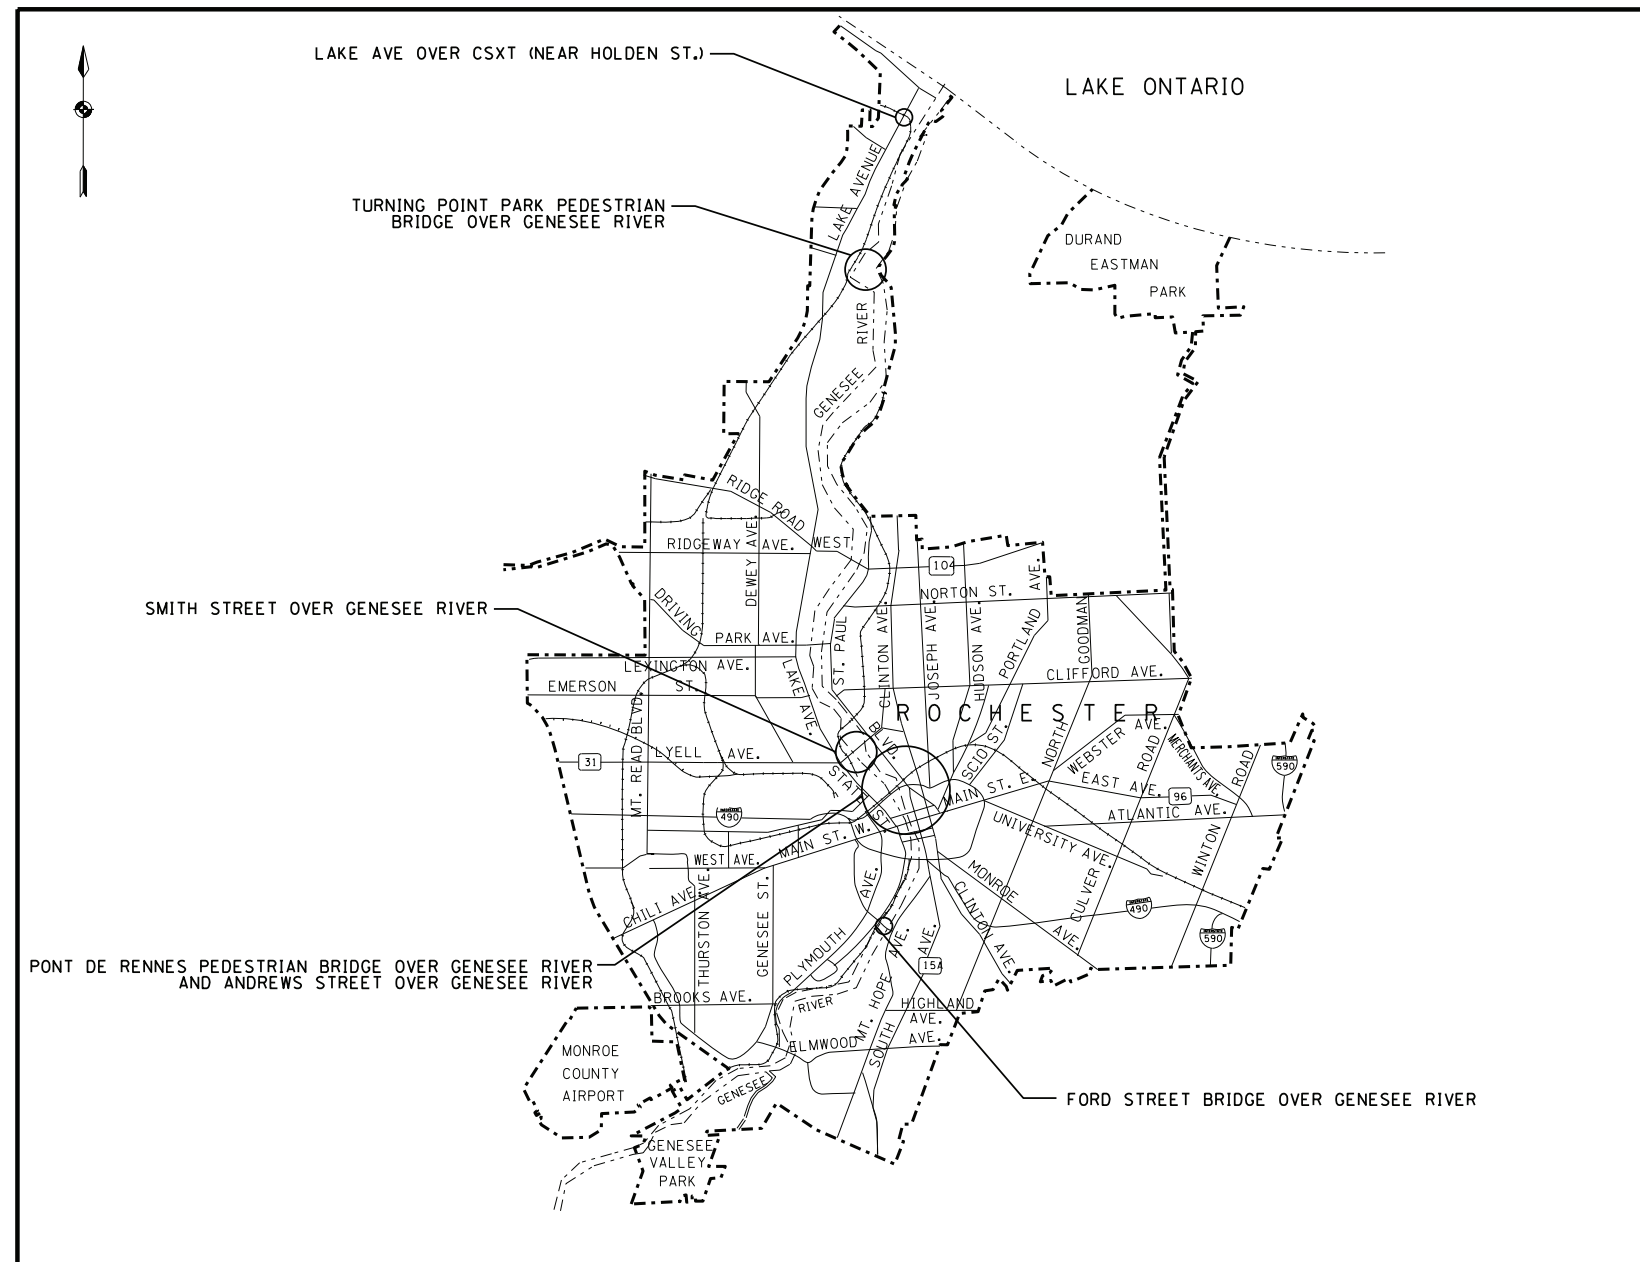

PROJECT SITE

Norman H. Jones 3.28.2016
 NORMAN H. JONES DATE
 COMMISSIONER, CITY OF ROCHESTER
 DEPARTMENT OF ENVIRONMENTAL SERVICES

James R. McIntosh 3/24/16
 JAMES R. MCINTOSH, P.E. DATE
 CITY ENGINEER
 CITY OF ROCHESTER

John M. Pappone 3/24/16
 JOHN M. PAPPONETTI, P.E. DATE
 N.Y.S.P.E. LICENSE NO. 083219



LABELLA
 Associates, D.P.C.

300 STATE STREET
 ROCHESTER, NY 14614
 P: (585) 454-6110
 F: (585) 454-3066

WWW.LABELLAPC.COM
 COPYRIGHT © 2016

GENERAL NOTES

1. MATERIAL AND CONSTRUCTION SPECIFICATIONS:
 - A. CITY OF ROCHESTER STANDARD CONSTRUCTION CONTRACT DOCUMENTS, NOVEMBER 1, 1991.
 - B. CONSTRUCTION AND MATERIALS, NEW YORK STATE DEPARTMENT OF TRANSPORTATION STANDARD SPECIFICATIONS, OFFICE OF ENGINEERING, DATED MAY 1, 2008 WITH CURRENT ADDITIONS AND MODIFICATIONS.
 - C. SPECIAL SPECIFICATIONS INCLUDED IN THE CONTRACT DOCUMENTS.
2. THE CONTRACTOR SHALL EXAMINE AND VERIFY IN THE FIELD ALL EXISTING AND GIVEN CONDITIONS AND DIMENSIONS WITH THOSE SHOWN ON THE CONTRACT PLANS, IF FIELD CONDITIONS AND DIMENSIONS DIFFER FROM THOSE SHOWN ON THE CONTRACT PLANS, THE CONTRACTOR SHALL USE THE FIELD CONDITIONS AND DIMENSIONS AND MAKE THE APPROPRIATE CHANGES TO THOSE SHOWN ON THE PLANS AS APPROVED BY THE ENGINEER. THE RESULTS OF THIS CHECK OF CONDITIONS AND DIMENSIONS SHALL BE SO NOTED ON THE DRAWINGS SUBMITTED FOR APPROVAL.
3. THERE SHALL BE NO CLAIM AGAINST THE CITY OF ROCHESTER MADE BY THE CONTRACTOR BETWEEN ACTUAL FIELD CONDITIONS AND THOSE SHOWN BY THE DETAILS AND DIMENSIONS ON THE CONTRACT PLANS. THE CONTRACTOR SHALL BE PAID AT THE UNIT BID PRICE FOR THE ACTUAL QUANTITIES OF MATERIALS USED OR FOR THE WORK PERFORMED AS INDICATED BY THE VARIOUS ITEMS IN THE CONTRACT.
4. IT SHALL BE THE CONTRACTOR'S OBLIGATION AND RESPONSIBILITY TO PROTECT AND DETERMINE THE EXACT LOCATION OF ANY UNDERGROUND UTILITIES. THE METHOD OF REMOVAL OF EXISTING ROADWAY, SHOULDER, SIDEWALK PAVEMENT, OR SOIL IN THE IMMEDIATE VICINITY OF ANY UNDERGROUND UTILITY SHALL BE SUBJECT TO THE APPROVAL OF THE ENGINEER.
5. THE CONTRACTOR IS ADVISED THAT ADDITIONAL NOTES WILL BE FOUND ON SUBSEQUENT SHEETS OF THE CONTRACT PLANS AND SUCH NOTES, WHILE PERTAINING TO THE SPECIFIC DRAWINGS THEY ARE PLACED ON, ALSO SUPPLEMENT THE GENERAL NOTES LISTED HEREIN.
6. NO PAYMENT SHALL BE MADE FOR WORK CALLED FOR BY NOTES ON THE CONTRACT PLANS, IN THE SPECIFICATIONS AND UNDER HEADING GENERAL NOTES UNLESS PAYMENT IS SPECIFICALLY INDICATED BY ITEM NUMBER. THE COST OF WORK FOR WHICH NO PAYMENT IS INDICATED SHALL BE INCLUDED IN THE UNIT PRICES BID FOR VARIOUS ITEMS OF THIS CONTRACT.
7. DIMENSIONS OF THE EXISTING STRUCTURES SHOWN ON THESE PLANS ARE FOR GENERAL REFERENCE ONLY. THEY HAVE BEEN TAKEN FROM THE ORIGINAL CONSTRUCTION DRAWINGS AND ARE NOT GUARANTEED. THE CONTRACTOR SHALL TAKE FIELD MEASUREMENTS AS NECESSARY TO ASSURE PROPER FIT OF THE FINISHED WORK, AND THE CONTRACTOR SHALL ASSUME FULL RESPONSIBILITY FOR THEIR ACCURACY. WHEN SHOP DRAWINGS BASED ON FIELD MEASUREMENTS ARE SUBMITTED FOR APPROVAL, THE FIELD MEASUREMENTS MADE SHALL BE INDICATED ON THE SHOP DRAWINGS SUBMITTED FOR REFERENCE OF THE REVIEWER.
8. THE CONTRACTOR SHALL VISIT THE SITES BEFORE SUBMITTING THEIR BID TO FAMILIARIZE THEMSELVES WITH THE PRESENT CONDITION AND TO JUDGE FOR THEMSELVES THE EXTENT AND NATURE OF THE WORK TO BE DONE UNDER THIS CONTRACT. NO EXTRA COMPENSATION SHALL BE ALLOWED TO THE CONTRACTOR BECAUSE OF FAILURE TO INCLUDE ALL ITEMS AND MATERIALS IN THE BID WHICH THE CONTRACTOR IS REQUIRED TO FURNISH IN ACCORDANCE WITH THE CONTRACT DOCUMENTS.
9. THE CONTRACTOR SHALL BE RESPONSIBLE FOR OBTAINING ALL PERMITS WHICH MAY BE REQUIRED TO PERFORM THE WORK AS INDICATED IN THE CONTRACT DOCUMENTS.
10. THE CONTRACTOR'S PROPOSED SCHEDULE SHALL BE SUBMITTED AT THE PRE-CONSTRUCTION MEETING AND ANY CHANGES OR MODIFICATIONS SHALL BE SUBMITTED TEN (10) CALENDAR DAYS PRIOR TO WORK STARTING AT A SPECIFIC SITE.
11. IF WORK OUTSIDE THE STREET RIGHT-OF-WAY IS REQUIRED, THE CONTRACTOR SHALL BE REQUIRED TO OBTAIN A "GRADING RELEASE" FROM THE RESPECTIVE PROPERTY OWNER.
12. THE CONTRACTOR SHALL PROTECT ALL CITY AND PRIVATELY OWNED EXISTING MATERIALS (INCLUDING LANDSCAPING) FROM DAMAGE OR DEFACEMENT WHICH MAY BE CAUSED BY HIS EQUIPMENT AND LABOR. SUCH DAMAGE SHALL BE PROPERLY CLEANED AND/OR REPAIRED/REPLACED TO THE SATISFACTION OF THE PROJECT ENGINEER AT NO COST TO THE CITY.
13. CONTRACTOR SHALL PROVIDE ACCESS TO THE REPAIRS TO THE EIC OR PROJECT ENGINEER.

RECONSTRUCTION NOTES

1. THE CONTRACTOR'S ATTENTION IS DIRECTED TO THE FACT THAT, DUE TO THE NATURE OF RECONSTRUCTION PROJECTS, THE EXACT EXTENT OF RECONSTRUCTION WORK CANNOT ALWAYS BE ACCURATELY DETERMINED PRIOR TO THE COMMENCEMENT OF WORK. THESE CONTRACT DOCUMENTS HAVE BEEN PREPARED BASED ON FIELD INSPECTION AND OTHER INFORMATION AVAILABLE AT THE TIME. ACTUAL FIELD CONDITIONS MAY REQUIRE MODIFICATIONS TO CONSTRUCTION DETAILS AND WORK QUANTITIES. THE CONTRACTOR SHALL PERFORM THE WORK IN ACCORDANCE WITH FIELD CONDITIONS.
2. THE CONTRACTOR SHALL PERFORM ALL WORK WITH CARE SO THAT ANY MATERIALS WHICH ARE TO REMAIN IN PLACE, OR WHICH ARE TO REMAIN THE PROPERTY OF THE CITY OF ROCHESTER, SHALL NOT BE DAMAGED. IF THE CONTRACTOR DAMAGES ANY MATERIALS WHICH ARE TO REMAIN IN PLACE, OR WHICH ARE TO REMAIN THE PROPERTY OF THE CITY OF ROCHESTER, THE DAMAGED MATERIALS SHALL BE REPAIRED OR REPLACED IN A MANNER SATISFACTORY TO THE ENGINEER AT THE EXPENSE OF THE CONTRACTOR.
3. WHENEVER ITEMS IN THE CONTRACT REQUIRE MATERIALS TO BE REMOVED AND DISPOSED OF, THE COST OF SUPPLYING A DISPOSAL AREA AND TRANSPORTATION TO THAT AREA SHALL BE INCLUDED IN THE UNIT PRICES BID FOR THOSE ITEMS.
4. ALL DETERIORATED CONCRETE SHALL BE REMOVED TO A DEPTH WHERE SOUND CONCRETE IS EXPOSED. BEFORE STARTING THIS WORK, THE CONTRACTOR SHALL SUBMIT TO THE ENGINEER FOR APPROVAL A PLAN SHOWING THE CONTRACTOR'S PROPOSED METHOD, EQUIPMENT, AND SEQUENCE FOR THE REMOVAL WORK. NO BLASTING OR DYNAMITING SHALL BE PERMITTED.
5. EXPOSED REINFORCING STEEL WHICH IS TO REMAIN IN THE STRUCTURE SHALL BE SAND BLAST CLEANED & PROTECTED FROM DAMAGE TO THE SATISFACTION OF THE ENGINEER. ALL EXPOSED EXISTING REINFORCEMENT TO REMAIN WHICH HAS BEEN DAMAGED BY THE CONTRACTOR'S CONSTRUCTION OPERATIONS SHALL BE REPLACED AT THE CONTRACTOR'S EXPENSE.
6. ALL NEW STEEL REINFORCEMENT USED IN THIS CONTRACT SHALL MEET THE REQUIREMENTS OF EPOXY COATED BAR REINFORCEMENT FOR STRUCTURES, ITEM 556.0202. COST OF SUPPLYING NEW EPOXY COATED BAR REINFORCEMENT SHALL BE INCLUDED IN THE COST FOR THE VARIOUS CONCRETE ITEMS.
7. ALL EXPOSED EDGES OF CONCRETE ARE TO BE CHAMFERED 3/4 INCH UNLESS OTHERWISE NOTED.
8. SURFACE OF NEW CONCRETE ARE TO BE RUBBED UPON REMOVAL OF THE FORMS TO THE SATISFACTION OF THE ENGINEER. THE COST TO BE INCLUDED IN THE PRICE BID FOR THE VARIOUS CONCRETE ITEMS.
9. DURING REMOVAL OPERATIONS, THE CONTRACTOR SHALL NOT BE ALLOWED TO DROP WASTE CONCRETE, DEBRIS AND OTHER MATERIAL TO THE AREA BELOW THE BRIDGE EXCEPT WHERE THE PLANS SPECIFICALLY PERMIT THE DROPPING OF MATERIAL. PLATFORMS, NETS, SCREENS OR OTHER PROTECTIVE DEVICES SHALL BE USED TO CATCH THE MATERIAL. IF THE ENGINEER DETERMINES THAT ADEQUATE PROTECTIVE DEVICES ARE NOT BEING EMPLOYED, THE WORK SHALL BE SUSPENDED UNTIL ADEQUATE PROTECTION IS PROVIDED.
10. ALL MATERIAL FALLING ON THE AREA BELOW AND ADJACENT TO THE BRIDGE SHALL BE REMOVED AND DISPOSED OF BY THE CONTRACTOR AT NO COST TO THE CITY.
11. THE COST OF FURNISHING, INSTALLING, MAINTAINING, REMOVING AND DISPOSING OF ALL PLATFORMS, NETS, SCREENS OR OTHER PROTECTIVE DEVICES SHALL BE INCLUDED IN THE UNIT PRICES BID FOR THE APPROPRIATE ITEMS OF THE CONTRACT.
12. ALL CONCRETE SURFACES RECEIVING NEW CONCRETE SHALL BE SANDBLASTED. PRIOR TO THE APPLICATION OF NEW CONCRETE, THE SURFACES SHALL BE AIR CLEANED THEN PRE-WET FOR 12 HOURS. THERE WILL BE NO SEPARATE PAYMENT FOR THIS WORK. THE COST SHALL BE INCLUDED IN THE UNIT PRICES BID FOR THE VARIOUS CONCRETE ITEMS IN THE CONTRACT.
13. THE CONTRACTOR SHALL KEEP ALL BRIDGE DRAINS CLEAN AND FREE FLOWING DURING THE LIFE OF THE CONTRACT. THE COST SHALL BE INCLUDED IN THE UNIT PRICES BID FOR THE VARIOUS SUPERSTRUCTURE ITEMS IN THE CONTRACT.

BASIC WORK ZONE TRAFFIC CONTROL NOTES

1. THE CONTRACTOR SHALL PROVIDE FOR SAFE VEHICULAR, PEDESTRIAN AND BICYCLE TRAFFIC AT ALL TIMES. PROPER WARNING, DANGER AND/OR DIRECTION SIGNS SHALL BE ERECTED AND MAINTAINED BY THE CONTRACTOR TO PROPERLY PROTECT AND DIRECT PUBLIC TRAVEL.
2. ALL BASIC WORK ZONE TRAFFIC CONTROL PLANS, DEVELOPED BY THE CONTRACTOR, SHALL BE SUBMITTED TO THE PROJECT ENGINEER A MINIMUM OF FIVE (5) DAYS PRIOR TO ITS RESPECTIVE INSTALLATION.
3. THE CONTRACTOR SHALL COORDINATE ALL WORK WITH THE CITY OF ROCHESTER'S SPECIAL EVENTS OFFICE (SEE SPECIAL EVENTS NOTES).
4. MINIMUM REQUIREMENTS FOR BASIC WORK ZONE TRAFFIC CONTROL ARE SHOWN ON DRAWINGS TCP-1 THROUGH TCP-2.
5. THE CONTRACTOR SHALL NOT PERFORM ANY CONSTRUCTION ACTIVITIES BETWEEN 5:00 PM AND 8:00 AM, UNLESS APPROVED BY THE ENGINEER.
6. THE CONTRACTOR IS RESPONSIBLE FOR HAVING EACH SITE CLEANED AND OPEN TO TRAFFIC EACH WEEKEND FOR THE DURATION OF THE CONTRACT. THIS WILL BE PERFORMED AT NO COST TO THE CITY.
7. CONSTRUCTION DURATION SHALL BE LIMITED TO A MAXIMUM OF TWO WEEKS PER SITE, UNLESS APPROVED BY THE PROJECT ENGINEER.

PAINTING NOTES

1. THE CONTRACTOR IS ADVISED THAT THE EXISTING PAINT SYSTEM ON PONT DE RENNES HAS NOT BEEN TESTED AND SHALL BE ASSUMED TO CONTAIN LEAD. THE STRUCTURAL STEEL PAINTING SHALL BE PERFORMED IN ACCORDANCE WITH THE NYS DOT STANDARD SPECIFICATIONS SECTIONS 570, 571 AND 574. COST FOR PAINT REMOVAL, CONTAINMENT, AND PAINTING OF THE NEW AND DAMAGED AREAS SHALL BE INCLUDED IN THE UNIT PRICE BID FOR THE APPLICABLE STEEL REPLACEMENT ITEM.
2. TOP COAT COLORS FOR EACH SITE ARE LISTED BELOW. THE CONTRACTOR MAY USE ANY PAINT SYSTEM FROM THE NYS DOT APPROVED MATERIALS LIST THAT IS APPROVED BY THE ENGINEER.

| | |
|---------------------------------|-----------------------|
| PONT DE RENNES STRUCTURAL STEEL | MATCH EXISTING |
| PONT DE RENNES BENCHES | MINERAL GRAY (SW2740) |
3. THE CONTRACTOR SHALL SUBMIT TOP COAT COLOR SAMPLES TO THE ENGINEER FOR APPROVAL PRIOR TO PERFORMING ANY SURFACE PREPARATION OR APPLYING ANY PAINT.
4. GROUND AND WATERWAY PROTECTION SHALL BE IMPLEMENTED AT EACH SITE WHERE PAINTING IS REQUIRED IN ACCORDANCE WITH THE REQUIREMENTS OF SECTION 570 IN THE NYS DOT STANDARD SPECIFICATIONS. COST TO BE INCLUDED IN THE UNIT BID PRICE FOR ITEM 574.01nnnn.

SPECIAL EVENT NOTES

1. A LIST OF SPECIAL EVENTS IS LISTED IN THE CONTRACT PROPOSAL BOOK. THIS LIST MAY NOT INCLUDE ALL SPECIAL EVENTS AND IT IS THE CONTRACTOR'S RESPONSIBILITY TO CONTACT ALL OF THE LISTED EVENT COORDINATORS AND BUSINESS OWNERS FOR A COMPLETE AND UPDATED LIST.
2. DURING ALL SPECIAL EVENTS HOSTED AT OR NEAR A WORK SITE, THE CONTRACTOR SHALL DELAY WORK AND CLEAN THE SITE AT NO CHARGE TO THE CITY TO ACCOMMODATE THE EVENT.

CONDUIT CAUTION NOTES

1. THE CONTRACTOR'S ATTENTION IS DIRECTED TO THE FACT THAT UTILITY CONDUITS MAY BE PRESENT IN THE STRUCTURAL SLABS, PARAPETS OR SIDEWALKS OF BRIDGES. THEIR EXISTENCE AND LOCATIONS SHALL BE FIELD VERIFIED. IF CONDUITS ARE PRESENT AND ARE ENCOUNTERED DURING CONSTRUCTION OPERATIONS, CARE SHALL BE EXERCISED NOT TO DAMAGE CONDUITS, EXPANSION COUPLINGS, OR CONTENTS OF CONDUITS. ANY DAMAGE SHALL BE REPAIRED TO THE SATISFACTION OF THE ENGINEER, AT NO COST TO THE CITY.
2. CHIPPING HAMMERS USED TO REMOVE CONCRETE NEAR CONDUIT EMBEDDED IN SIDEWALK SHALL NOT EXCEED 15 LBS. IN WEIGHT WITH THE BIT REMOVED.

| INDEX OF DRAWINGS | | |
|-------------------|---|----------|
| DWG. NO. | TITLE | SHT. NO. |
| N-1 | COVER SHEET | 1 |
| EQ-1 | GENERAL NOTES AND INDEX | 2 |
| S-1 | ESTIMATE OF QUANTITIES | 3 |
| S-2 | ANDREWS STREET PLAN AND ELEVATION | 4 |
| S-3 | ANDREWS STREET DETAILS | 5 |
| S-4 | FORD STREET OVER GENESEE RIVER PLAN AND ELEVATION | 6 |
| S-5 | FORD STREET OVER GENESEE RIVER/BIKE PATH PLAN AND ELEVATION | 7 |
| S-6 | LAKE AVENUE (NEAR HOLDEN) PLAN | 8 |
| S-7 | LAKE AVENUE DETAILS & PAVEMENT MARKINGS | 9 |
| S-8 | PONT DE RENNES GENERAL PLAN AND SECTION | 10 |
| S-9 | PONT DE RENNES REPAIR LOCATIONS BRIDGE ELEVATIONS | 11 |
| S-10 | PONT DE RENNES REPAIR DETAILS - 1 | 12 |
| S-11 | PONT DE RENNES REPAIR DETAILS - 2 | 13 |
| S-12 | PONT DE RENNES REPAIR DETAILS - 3 | 14 |
| S-13 | PONT DE RENNES REPAIR DETAILS - 4 | 15 |
| S-14 | PONT DE RENNES TIMBER BENCH REPAIR LOCATIONS AND DETAILS | 16 |
| S-15 | SMITH STREET PLAN AND ELEVATION | 17 |
| S-16 | TURNING POINT PARK PEDESTRIAN BRIDGE PLAN AND SECTION | 18 |
| TCP-1 | TURNING POINT PARK DETAILS | 19 |
| TCP-2 | TYPICAL BASIC WORK ZONE TRAFFIC CONTROL PLAN | 20 |
| | PEDESTRIAN BRIDGE BASIC WORK ZONE TRAFFIC CONTROL PLAN | 21 |

DESIGNER: PL01DRA1 BW Hall, J.H. 6/10/10
 MODEL: Definit
 PROJECT: 212470.01 - Bridge & Structural Design Services/Drawings/Structural/PC2010/Notes.dgn
 DATE: 6/10/10
 PROJECT MANAGER: 1146801 AH



RECORD PLANS

I HEREBY CERTIFY BY MY SIGNATURE, THAT I HAVE PREPARED THIS RECORD DRAWING WHICH IS, TO THE BEST OF MY KNOWLEDGE, INFORMATION AND BELIEF, A TRUE REPRESENTATION OF THE WORK AS CONSTRUCTED.

DATE: _____


| NO. | REVISION | BY | DATE |
|-----|----------|----|------|
| 1 | | | |
| 2 | | | |
| 3 | | | |
| 4 | | | |
| 5 | | | |

It is a violation of New York Education Law Article 145 Sec.7209, for any person, unless acting under the direction of a licensed architect, professional engineer, or land surveyor, to alter an item in any way, if an item bearing the seal of an architect, engineer, or land surveyor is altered; the altering architect, engineer, or land surveyor shall affix to the item their seal and notation "altered by" followed by their signature and date of such alteration, and a specific description of the alteration.

LABELLA

Associates, P.C.

300 STATE STREET
ROCHESTER, NY 14614

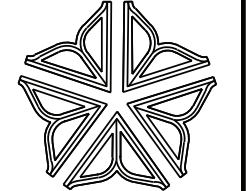

PROJECT/CLIENT
**MAINTENANCE REPAIRS TO CITY BRIDGES
 AND VARIOUS FACILITIES**
 F.Y. 2016
CITY OF ROCHESTER
 DEPARTMENT OF ENVIRONMENTAL SERVICES

DRAWING TITLE
GENERAL NOTES AND INDEX

| |
|------------------------------------|
| PROJECT NUMBER 212470.02 |
| DATE |
| BID |
| DRAWING NUMBER N-1 |

ESTIMATE OF QUANTITIES

| ITEM NO. | DESCRIPTION | UNIT | ESTIMATED | FINAL |
|--------------|---|------|-----------|-------|
| 207.21 | GEOTEXTILE SEPARATION | SY | 30 | |
| 555.09 | CONCRETE FOR STRUCTURES, CLASS HP | CY | 3 | |
| 556.03 | STUD SHEAR CONNECTORS FOR BRIDGES | EA | 68 | |
| 557.0109 | SUPERSTRUCTURE SLAB WITH INTEGRAL WEARING SURFACE - BOTTOM FORMWORK REQUIRED - TYPE 9 FRICTION | SY | 21 | |
| 559.17960008 | PROTECTIVE SEALING OF STRUCTURAL CONCRETE FOR EXISTING BRIDGE DECKS & SIDEWALKS | SF | 117800 | |
| S560.1301 | REMOVE AND RESET STONE PANEL | SF | 57 | |
| S562.0101 | CONCRETE JOINT SEALING - TYPE A | LF | 140 | |
| S562.0102 | CONCRETE JOINT SEALING - TYPE B | LF | 125 | |
| 564.700001 | STRUCTURAL STEEL REPLACEMENT - BOTTOM CHORD SPLICE REPAIR | EA | 3 | |
| 564.700002 | STRUCTURAL STEEL REPLACEMENT - FASCIA STRINGER WEB REPAIR | EA | 12 | |
| 564.700003 | STRUCTURAL STEEL REPLACEMENT - STRINGER BOTTOM FLANGE REPAIR | EA | 2 | |
| 564.700004 | STRUCTURAL STEEL REPLACEMENT - STRINGER TOP FLANGE REPAIR | EA | 4 | |
| 571.03 | DISPOSAL OF HAZARDOUS PAINT REMOVAL WASTE CONTAINING LEAD | LB | 500 | |
| 570.01 | LEAD EXPOSURE CONTROL PLAN | LS | NEC | |
| 570.02 | MEDICAL TESTING | DC | 500 | |
| 570.03 | PERSONAL-EXPOSURE-MONITORING SAMPLE ANALYSIS | DC | 500 | |
| 580.01 | REMOVAL OF STRUCTURAL CONCRETE | CY | 3 | |
| 580.03 | REMOVAL OF STEEL SUPPORTED STRUCTURAL SLAB (WITHOUT SHEAR CONNECTORS) | SF | 185 | |
| 582.06 | REMOVAL OF STRUCTURAL CONCRETE - REPLACEMENT WITH CLASS D | SF | 305 | |
| 584.50000018 | THIN EPOXY POLYMER OVERLAY WEARING SURFACE FOR STRUCTURAL SLABS | SF | 300 | |
| 594.03 | TREATED LUMBER DECK SYSTEM | CF | 87 | |
| S594.04 | TIMBER BENCH REPAIR | EA | 107 | |
| 608.03040109 | REMOVE, STORE AND RESET CONCRETE BLOCK PAVERS | SY | 30 | |
| S615.20 | CLEAN AND PAINT BENCHES | LS | NEC | |
| 619.0101 | BASIC WORK ZONE TRAFFIC CONTROL (DAILY OPERATIONS) | LS | NEC | |
| 625.01 | SURVEY OPERATIONS | LS | NEC | |
| S633.9401 | MAINTENANCE CLEANING AND WASHING OF BRIDGES (LAKE AVENUE OVER CSXT) | LS | NEC | |
| S633.9402 | MAINTENANCE CLEANING AND WASHING OF BRIDGES (FORD STREET OVER GENESEE RIVER/BIKE PATH) | LS | NEC | |
| S633.9403 | MAINTENANCE CLEANING AND WASHING OF BRIDGES (PONT DE RENNES PEDESTRIAN BRIDGE OVER GENESEE RIVER) | LS | NEC | |
| S633.9404 | MAINTENANCE CLEANING AND WASHING OF BRIDGES (SMITH STREET OVER GENESEE RIVER) | LS | NEC | |
| 685.12 | YELLOW EPOXY REFLECTORIZED PAVEMENT STRIPES - 20 MILS | LF | 120 | |
| 699.040001 | MOBILIZATION | LS | NEC | |
| S999.02 | PROJECT SIGN | EA | 2 | |
| S999.89 | ACID STAIN CONCRETE SURFACES | SF | 1395 | |

PLOT/DRAW: BW_Hall.dwg
 MODEL: Design
 DATE: 07/23/16
 PROJECT MANAGER: 11:45:19 AM
 PROJECT NUMBER: 212470.02
 DESIGNER:



RECORD PLANS

I HEREBY CERTIFY BY MY SIGNATURE, THAT I HAVE PREPARED THIS RECORD DRAWING WHICH IS, TO THE BEST OF MY KNOWLEDGE, INFORMATION AND BELIEF, A TRUE REPRESENTATION OF THE WORK AS CONSTRUCTED.


DATE: _____

| NO. | REVISION | BY | DATE |
|-----|----------|----|------|
| 1 | | | |
| 2 | | | |
| 3 | | | |
| 4 | | | |
| 5 | | | |

It is a violation of New York Education Law Article 145 Sec.7209, for any person, unless acting under the direction of a licensed architect, professional engineer, or land surveyor, to alter an item in any way; if an item bearing the seal of an architect, engineer, or land surveyor is altered; the altering architect, engineer, or land surveyor shall affix to the item their seal and notation "altered by" followed by their signature and date of such alteration, and a specific description of the alteration.

LABELLA
Associates, D.P.C.

300 STATE STREET
ROCHESTER, NY 14614

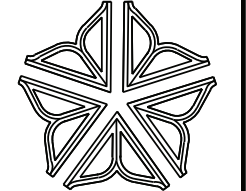

PROJECT/CLIENT

MAINTENANCE REPAIRS TO CITY BRIDGES
AND VARIOUS FACILITIES
F.Y. 2016
CITY OF ROCHESTER
DEPARTMENT OF ENVIRONMENTAL SERVICES

DRAWING TITLE


ESTIMATE OF QUANTITIES

PROJECT NUMBER
212470.02


DATE

BID

DRAWING NUMBER
EQ-1

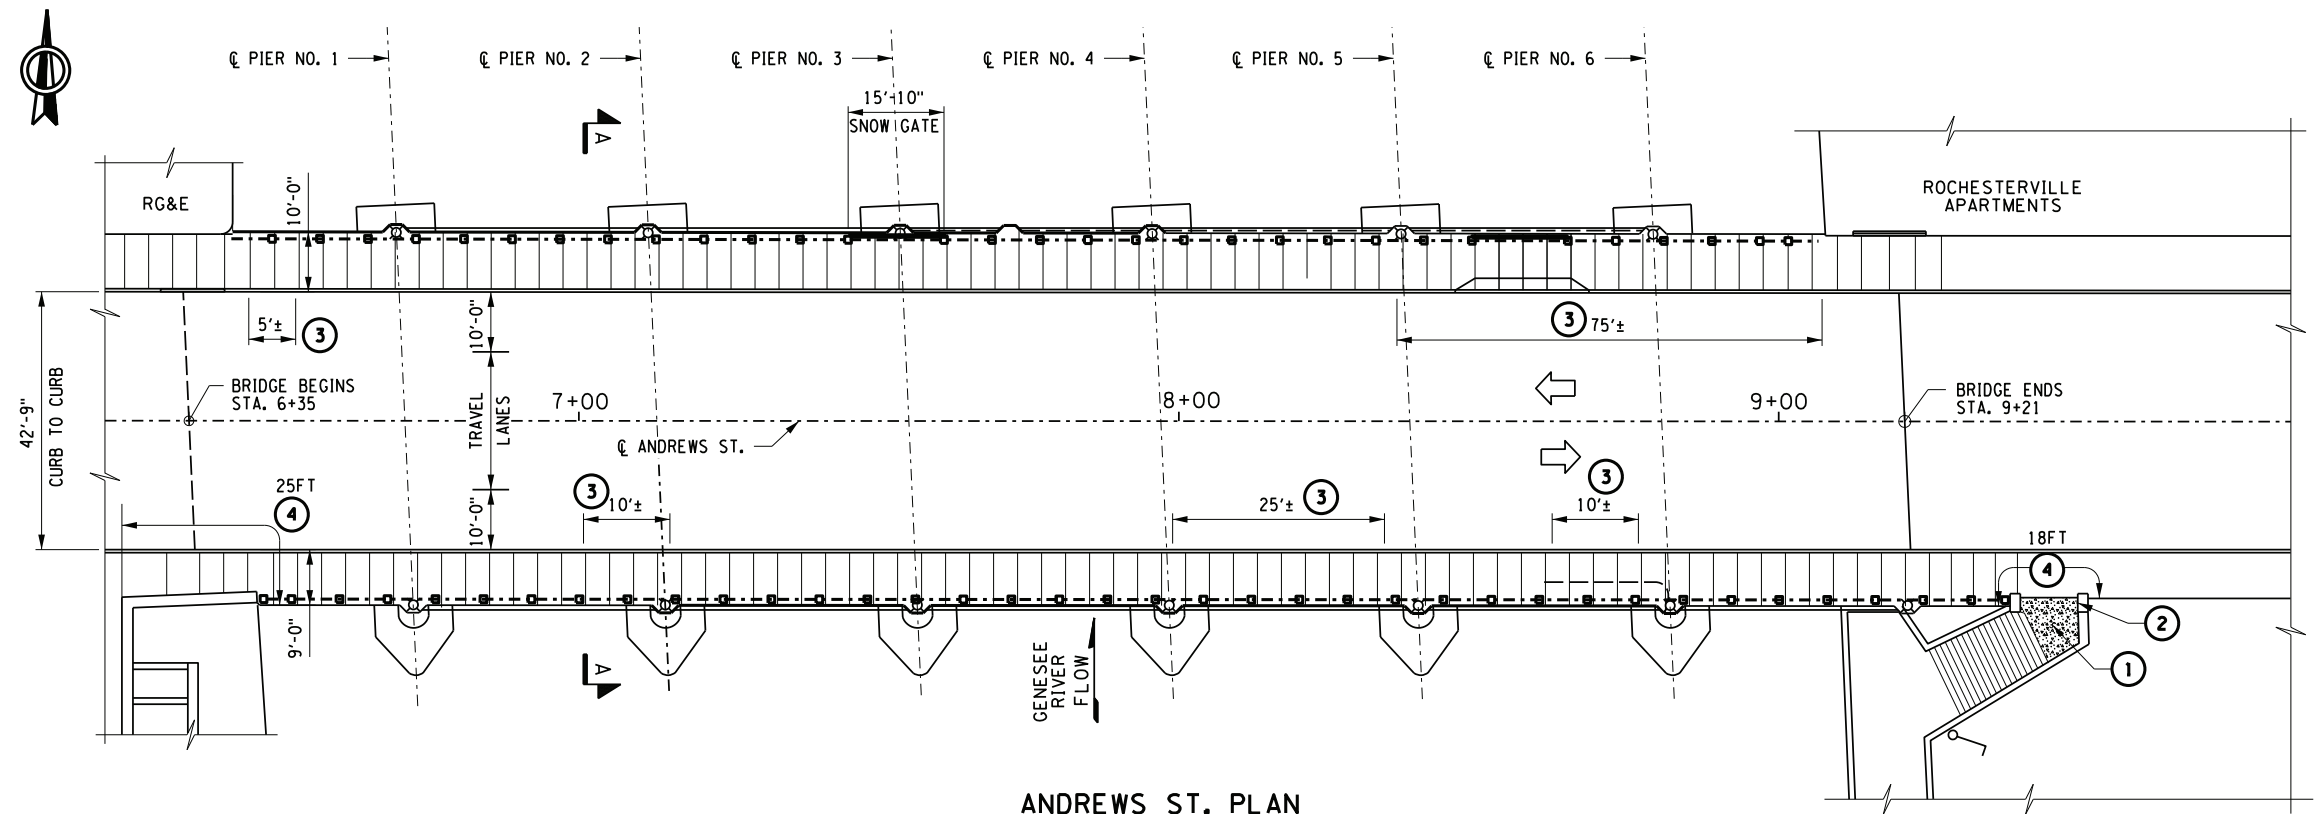

ANDREWS ST. PLAN
SCALE: 1/16" = 1'-0"

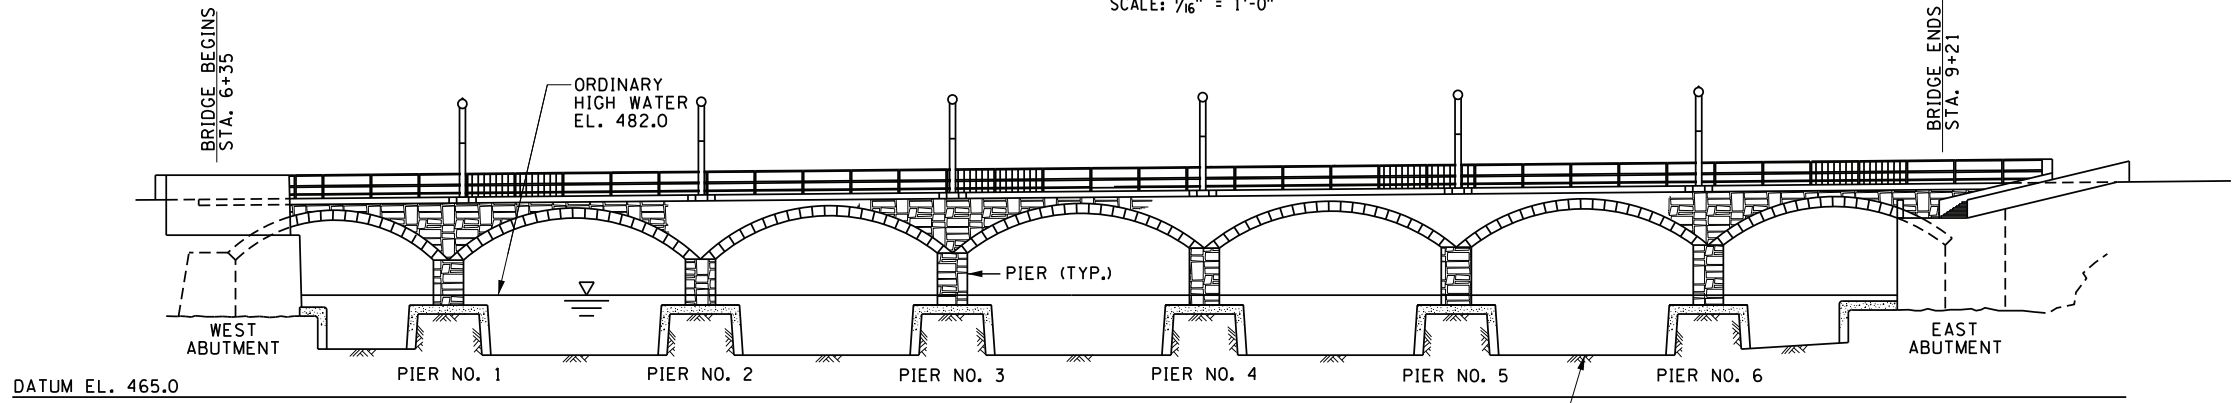

ANDREWS ST. SOUTH ELEVATION
SCALE: 1/16" = 1'-0"

| CONSTRUCTION LEGEND | |
|---------------------|---|
| ① | - RESET GRANITE STONE SLABS (SEE NOTE 3) ITEM S560.1301 |
| ② | - RESET GRANITE PANEL (SEE NOTE 3) ITEM S560.1301 |
| ③ | - SEAL JOINT BETWEEN SIDEWALK AND CURB (TYPE B), ITEM S562.0102 |
| ④ | - SEAL JOINT BETWEEN SIDEWALK AND RETAINING WALL (TYPE A), ITEM S562.0101 |

- NOTES:**
- FOR THE FOLLOWING SEE:

| | |
|---|-------|
| A. GENERAL NOTES..... | N-1 |
| B. ANDREWS ST. DETAILS..... | S-2 |
| C. BASIC WORK ZONE TRAFFIC CONTROL..... | MPT-1 |
 - CONTRACTOR SHALL COORDINATE WITH THE CITY OF ROCHESTER'S, PERMITS OFFICE TO SECURE WORKING AREA WITHIN EXISTING PARKING LANES.
 - COST TO REGRADE AND COMPACT SUBBASE TO BE INCLUDED IN BID PRICE FOR ITEM S560.1301. REFER TO RESETTING DETAIL ON DRAWINGS S-2.

PLODRA BW_Hall_01610
 MODEL: 11/14/16
 DATE: 11/14/16
 PROJECT: 212470.01 - Bridge & Structural Design Services/Drawings/Structural/P2016/Andrews Street.dgn
 PROJECT MANAGER: DESIGNER: ENGINEER:



RECORD PLANS


I HEREBY CERTIFY BY MY SIGNATURE, THAT I HAVE PREPARED THIS RECORD DRAWING WHICH IS, TO THE BEST OF MY KNOWLEDGE, INFORMATION AND BELIEF, A TRUE REPRESENTATION OF THE WORK AS CONSTRUCTED.

DATE: _____

| NO. | REVISION | BY | DATE |
|-----|----------|----|------|
| 1 | | | |
| 2 | | | |
| 3 | | | |
| 4 | | | |
| 5 | | | |

LABELLA
Associates, D.P.C.

300 STATE STREET
ROCHESTER, NY 14614

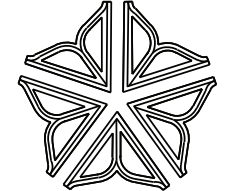

PROJECT/CLIENT

MAINTENANCE REPAIRS TO CITY BRIDGES
AND VARIOUS FACILITIES
F.Y. 2016
CITY OF ROCHESTER
DEPARTMENT OF ENVIRONMENTAL SERVICES

DRAWING TITLE






ANDREWS STREET
PLAN AND ELEVATION

PROJECT NUMBER
212470.02

DATE

BID

DRAWING NUMBER
S-1

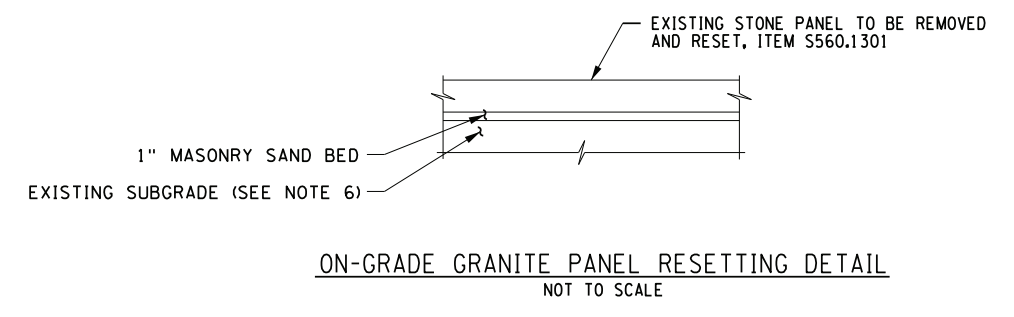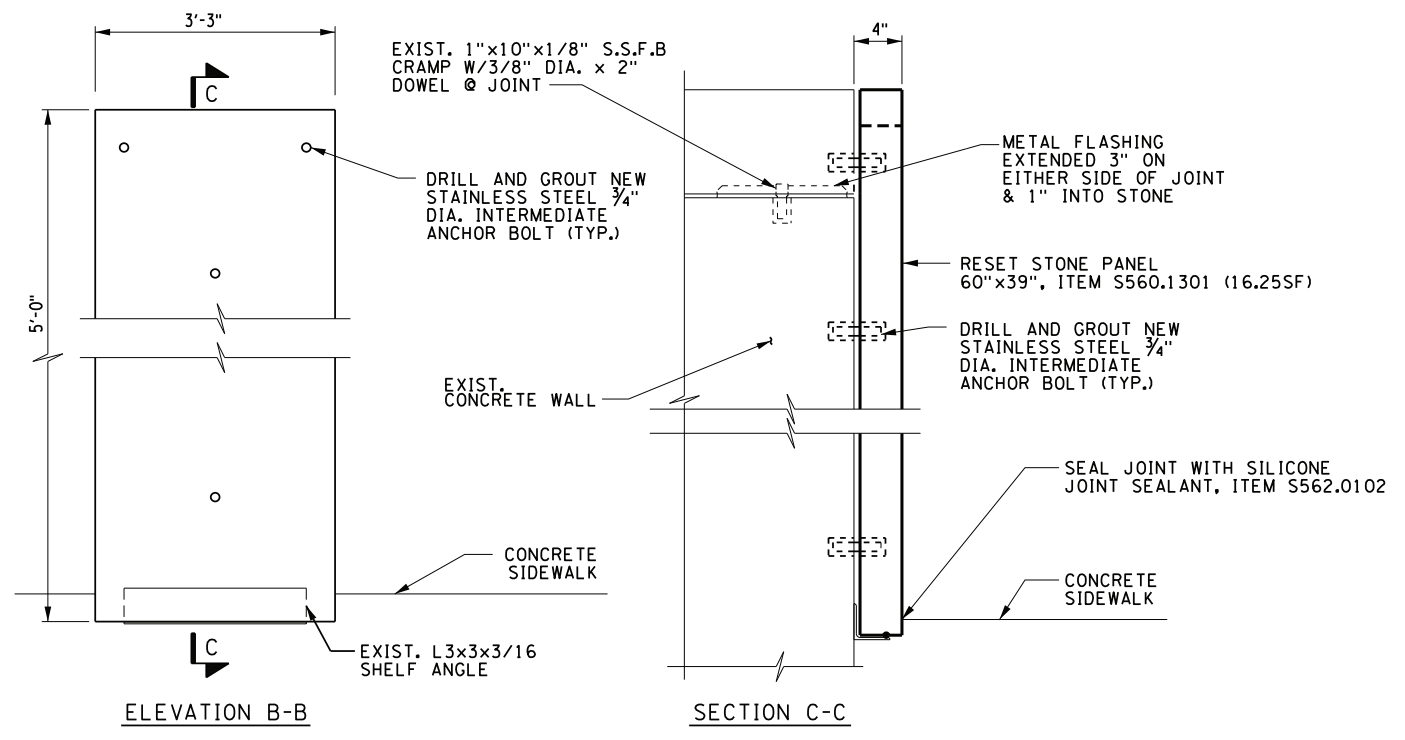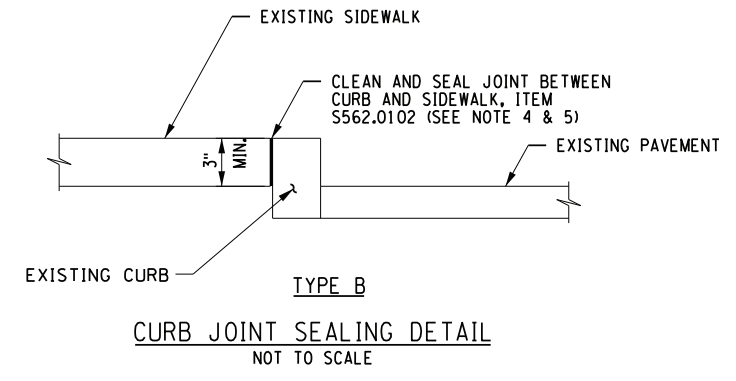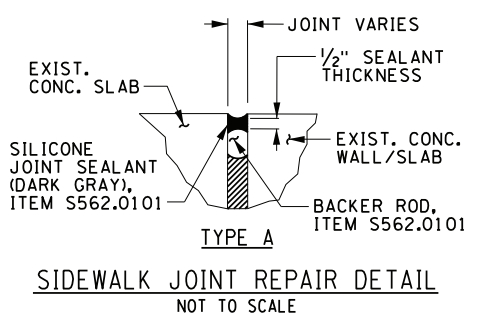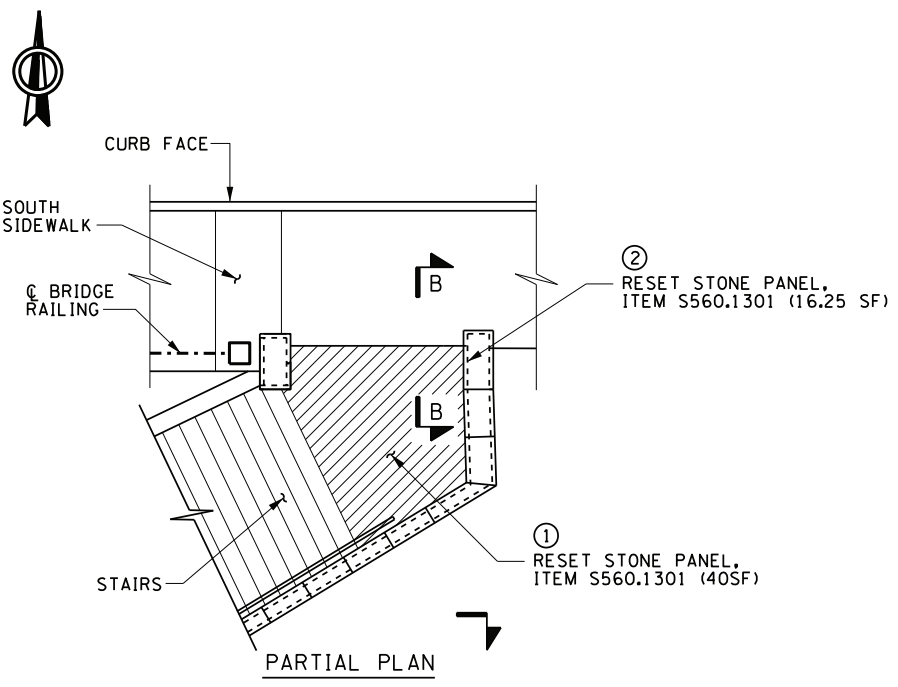

NOTES:

- FOR THE FOLLOWING SEE:

| | |
|--|---------------|
| DWG. NO. | |
| A. GENERAL NOTES | N-1 |
| B. ANDREWS ST. PLAN & ELEVATION | S-1 |
| C. MAINTENANCE AND PROTECTION OF TRAFFIC | MPT-1 & MPT-2 |
- LOCATIONS WHERE EXISTING JOINT OR CRACK SEALANT IS STILL PRESENT SHALL NOT BE ROUTED. JOINT MATERIAL SHALL BE REMOVED BY METHODS THAT WILL NOT DAMAGE THE ADJACENT CONCRETE.
- THE CONTRACTOR SHALL MAINTAIN PEDESTRIAN TRAFFIC ON ONE SIDEWALK AT ALL TIMES THROUGH THE CONSTRUCTION SITE. COST TO BE INCLUDED IN ITEM 619.0101.
- THE JOINT BETWEEN SIDEWALK AND CURB SHALL BE FULLY CLEANED WITH A MINIMUM 3000 PSI PRESSURE WASHER AND COMPRESSED AIR. CLEANING SHALL BE ADEQUATE FOR SEALANT BOND AND TO THE SATISFACTION OF THE ENGINEER. COST TO BE INCLUDED IN ITEM S562.0102.
- SEALANT SHALL BE POLY-CARB MARK 170.2 BASE COAT OR APPROVED EQUIVALENT. EPOXY SHALL BE MIXED AND INSTALLED IN ACCORDANCE WITH MANUFACTURER'S WRITTEN INSTRUCTIONS.
- CONTRACTOR SHALL REGRADE EXISTING SUBGRADE AS REQUIRED TO RESET THE STONE PANEL. A NEW 1" THICK LAYER OF MASONRY SAND SHALL BE INSTALLED PRIOR TO RESETTING. COST TO BE INCLUDED IN ITEM S560.1301.

PLOT/DRAW: BW_Hall.dwg
 MODEL: Detail
 PROJECT: Projects/Projects/2016/Andrews Street Details.dwg
 DATE: 07/23/16
 TIME: 11:48:49 AM
 PROJECT MANAGER:

DESIGNER:

 ENGINEER:



RECORD PLANS

I HEREBY CERTIFY BY MY SIGNATURE, THAT I HAVE PREPARED THIS RECORD DRAWING WHICH IS, TO THE BEST OF MY KNOWLEDGE, INFORMATION AND BELIEF, A TRUE REPRESENTATION OF THE WORK AS CONSTRUCTED.


DATE: _____

| NO. | REVISION | BY | DATE |
|-----|----------|----|------|
| 1 | | | |
| 2 | | | |
| 3 | | | |
| 4 | | | |
| 5 | | | |

It is a violation of New York Education Law Article 145 Sec.7209, for any person, unless acting under the direction of a licensed architect, professional engineer, or land surveyor, to alter an item in any way, if an item bearing the seal of an architect, engineer, or land surveyor is altered; the altering architect, engineer, or land surveyor shall affix to the item their seal and notation "altered by" followed by their signature and date of such alteration, and a specific description of the alteration.

LABELLA
Associates, P.C.

300 STATE STREET
ROCHESTER, NY 14614

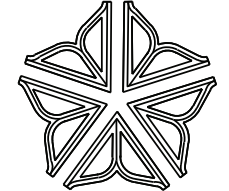

PROJECT/CLIENT

MAINTENANCE REPAIRS TO CITY BRIDGES
AND VARIOUS FACILITIES
F.Y. 2016
CITY OF ROCHESTER
DEPARTMENT OF ENVIRONMENTAL SERVICES

DRAWING TITLE

ANDREWS STREET
DETAILS

PROJECT NUMBER
212470.02

DATE

BID

DRAWING NUMBER
S-2